

BUILDING DEPARTMENT

Checked by: *JM* Date: 12-12-16


- GENERAL NOTES
- 1- GRADING TO BE DESIGNED BY REGISTERED LAND SURVEYOR
 - 2- LATEST REVISION OF ONTARIO BUILDING CODE IS THE BASIS OF THIS DESIGN
 - 3- REPORT ANY DISCREPANCIES TO CONSULTANT BEFORE PROCEEDING WITH WORK

No person shall construct or demolish a building or cause a building to be constructed or demolished except in accordance with the plans, specifications, documents and any other information on the basis of which a permit was issued or any charges to them authorized by the Chief Building Official.

1992, c. 23, s. 8(8) - (13)


APPROVED	APPROVED AS NOTED	REVISE AND RESUBMIT
	✓	

CONNECT SANITARY, STORM AND WATER SERVICES TO MUNICIPAL SERVICES

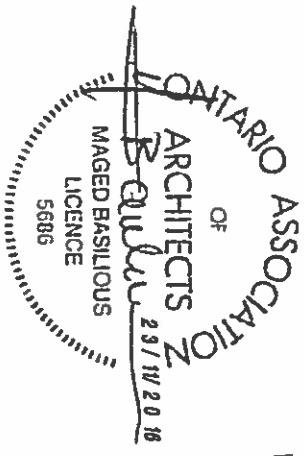

The building site plan complies with R-1 zone of the Comprehensive Zoning By-Law 1-2014 Subsection C-1-1 for the Town of Kingsville.

Date: *12-12-16* Signature: *[Signature]*

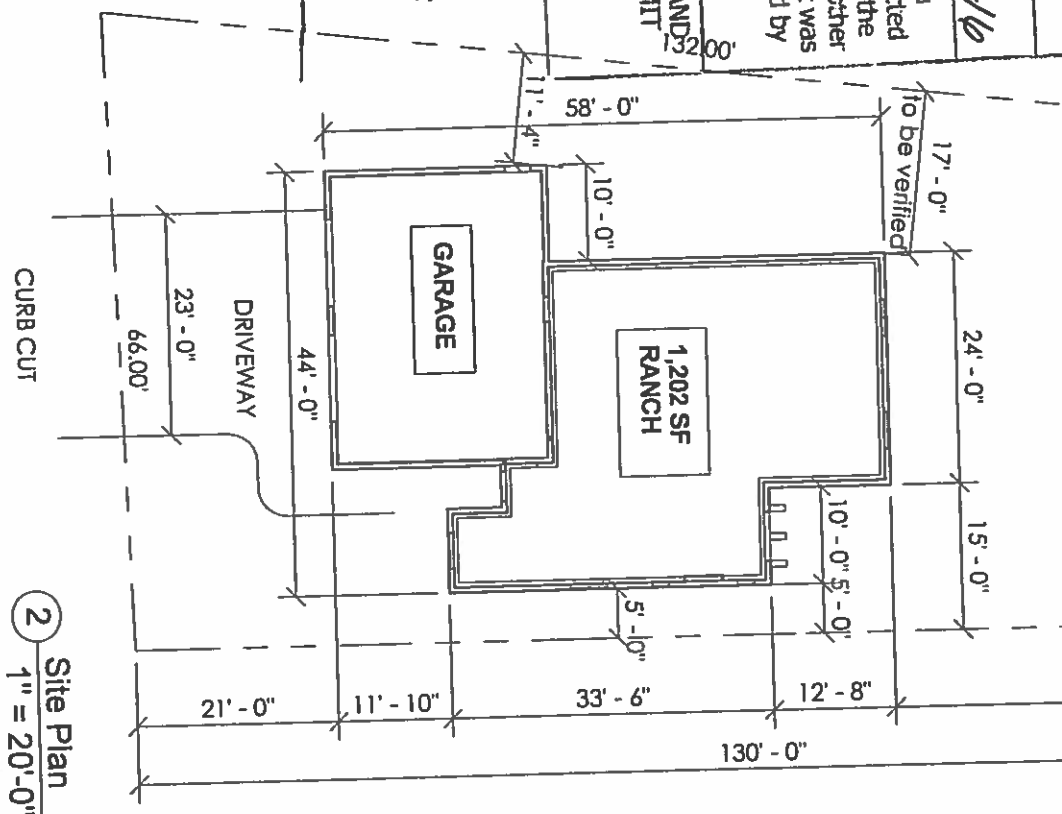

2 Site Plan
1" = 20'-0"

Site Plan & Roof Plan

A3

Project number	362
Date	Nov 17, 2016
Drawn by	D.B.
Checked by	M.B.

RANCH HOUSE
1,202 SF RANCH
KINGSVILLE, ON



Maged Basillious Architect
www.mbachitect.ca
1635 Ottawa St., Windsor, Ontario, N8Y 1R2
T 519-969-0086 - email: mbasillious@mbachitect.ca