


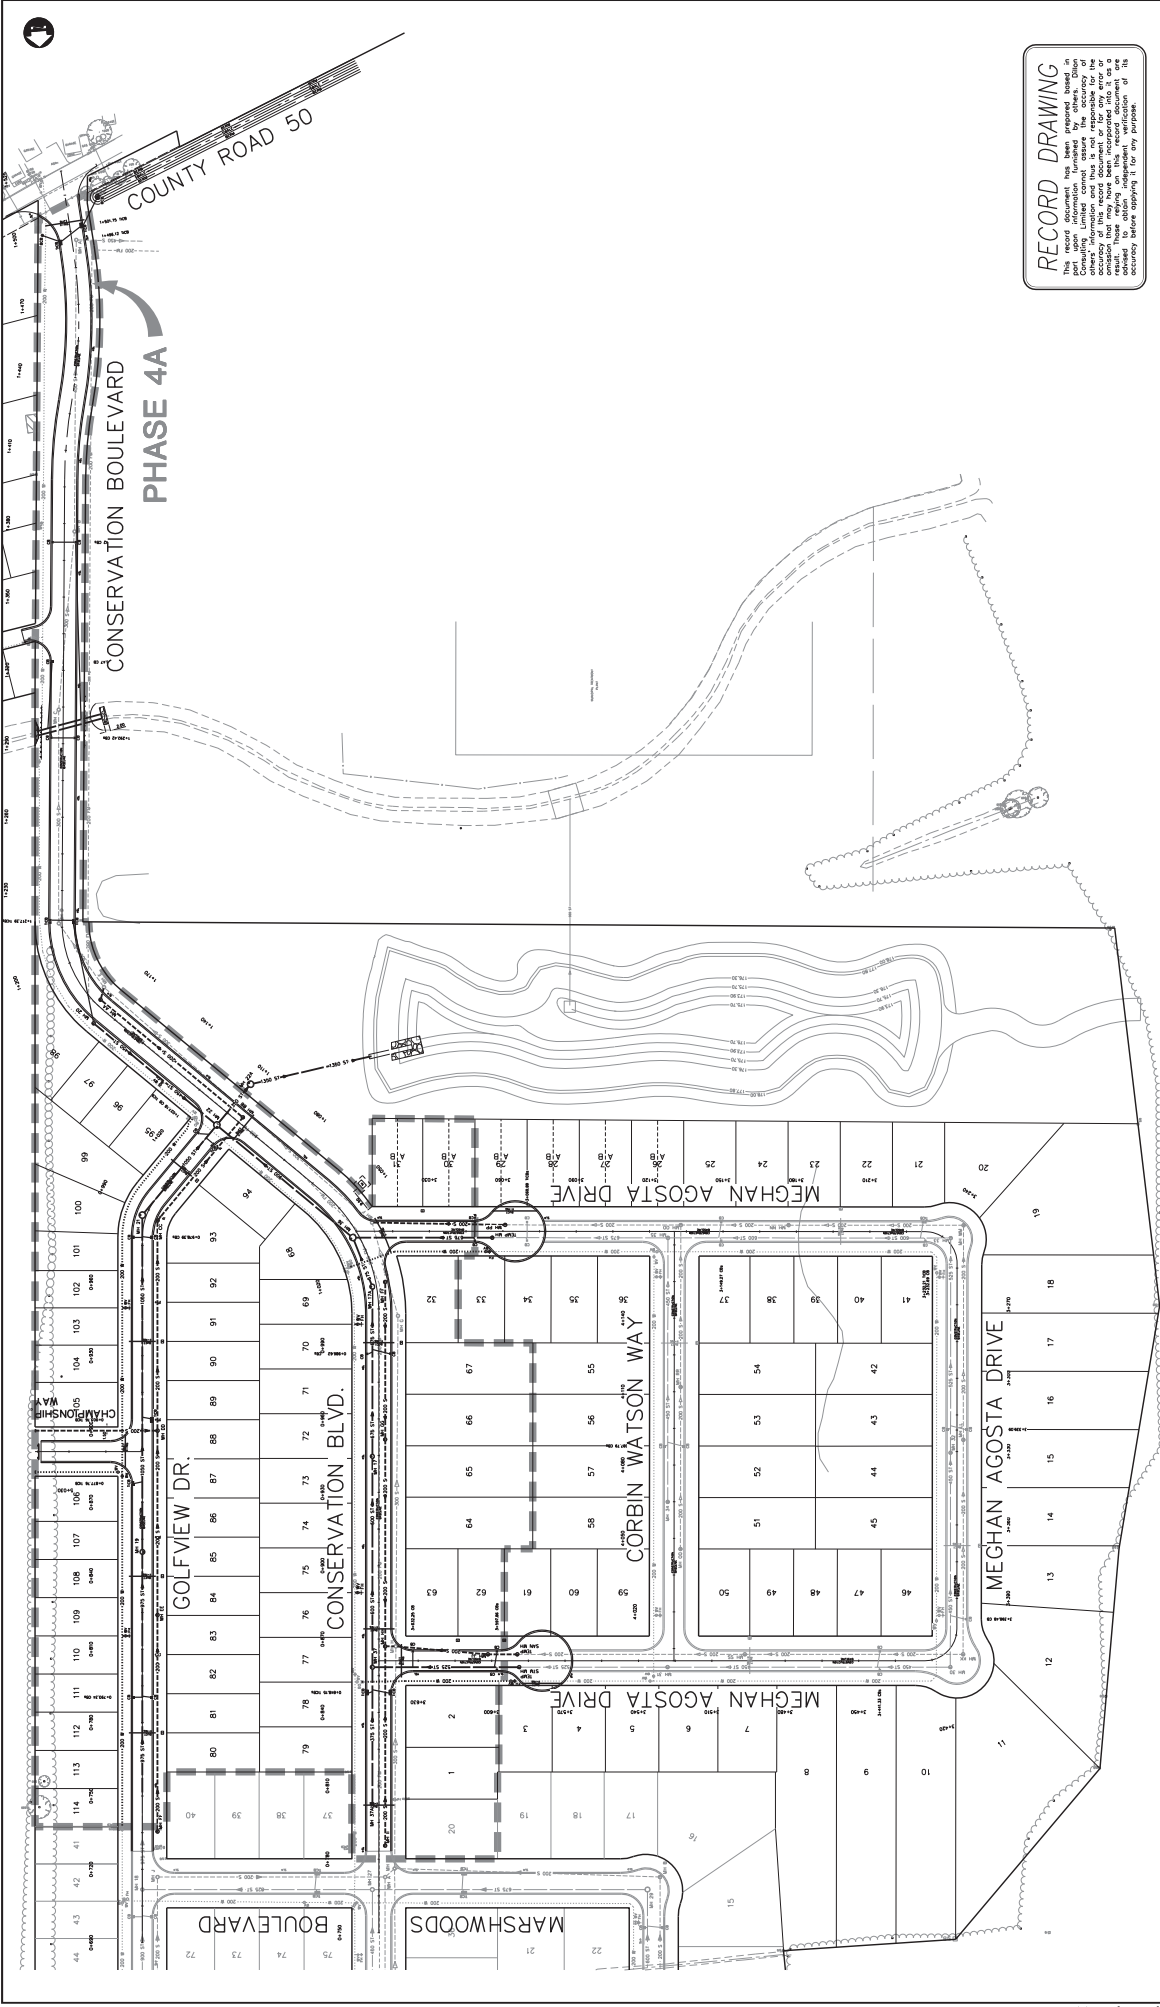

RECORD DRAWING

This record document has been prepared based on information furnished by the owner. Dillen Consulting Limited and its staff are not responsible for the accuracy of the information and that it is not a warranty, representation or agreement. It is a condition that may have been incorporated into the contract. The user of this drawing is advised to obtain independent verification of the accuracy where necessary, for any purpose.

Conditions of Use Verify dimensions and/or dimensions on drawing prior to use. Report any discrepancies to Dillon Consulting Limited. Do not scale dimension from drawing. Do not modify drawing, re-use it, or use for purposes other than those intended. The user of this drawing is advised to obtain independent verification of the accuracy where necessary, for any purpose.	RECORD DRAWING	1156722 ONTARIO LIMITED		York Subdivision Phase 4A										PROJECT NO. 1254115-1000
				SITE SERVICES & PHASING PLAN										SHEET NO. 1