


LAND	USE	SCHEDULE

		LAND USE SCHEDULE						
RESIDENTIAL			RESIDENTIA		LAND USE SCHEDULE			
UNITS	AREA(Ha)	USE	UNITS	AREA(Ha)		RESIDENTIA	4L	
27	2.18	SINGLE FAMILY DWELLING	59	4.76	USE	UNITS	AREA(Ha)	
48	2.54	SEMI-DETACHED	0	0	SINGLE FAMILY DWELLING	85	7.19	
	1.25	R.O.W.		1.22	SEMI-DETACHED	106	4.38	
	0.01	INSTITUTION (BLOCK 62)		10.16	R.O.W.		2.96	
		BLOCKS 60 & 61		0.03	SWM POND AND FLOOD PLAIN		1.61	
75	5.98				BLOCKS 140 & 141		0.03	
		TOTAL	59	16.17	TOTAL	191	16.17	

			1				DECION		DDO FOT NO
			5.	REVISED REDLINE AMENDED DRAFT PLAN	AUG. 28, 202	20 D.L. R.C.S.	DESIGN R.C.S.	Remark Farms	PROJECT NO.
			4.	REVISED REDLINE AMENDED DRAFT PLAN (SUBMISSION)	AUG. 7, 2020	D.L. R.C.S.	CHECKED R.C.S.	Remark Farms	21–1113
			3.	RED LINE REVISION	JAN. 16, 2018	8 D.L. R.C.S.	DRAWN S.M.L.		SHEET NO.
			2.	SUBMITTED TO COUNTY OF ESSEX	FEB 28, 2013	3 A.B. R.C.S.	CHECKED R.C.S.	REVISED	1
			1.	SUBMITTED TO TOWN	JAN 16, 2013	6 R.C.S. R.C.S.	DATE JAN 2013	AMENDED DRAFT PLAN	I
NO. REVISION	DATE	BY APP.	NO.	REVISION	DATE	BY APP.	SCALE 1:1000		<sup>OF</sup> 1

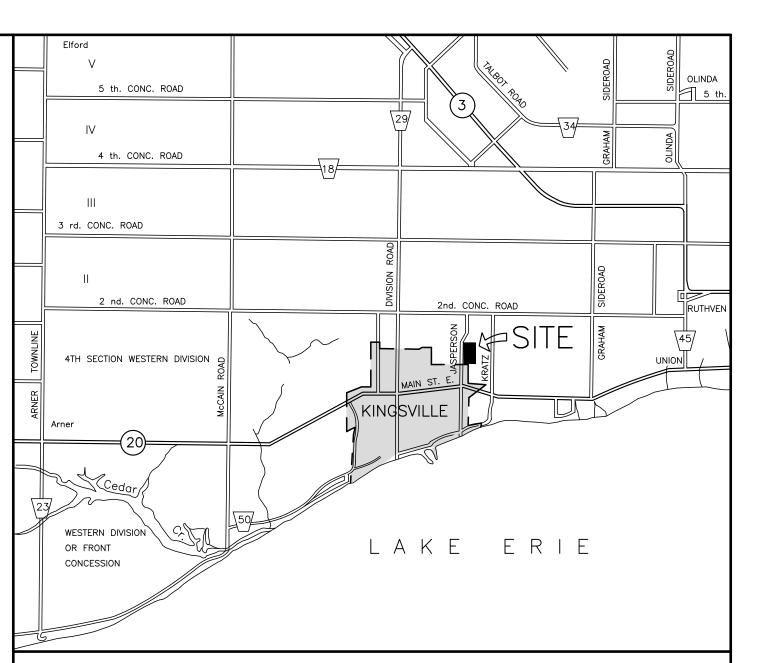

## KEY PLAN

	ATION REQUIRED UNDER F THE PLANNING ACT
(a)	SHOWN ON PLAN
(b)	SHOWN ON KEY PLAN
(c)	SHOWN ON PLAN
(d)	RESIDENTIAL SINGLE DWELLING
(e)	AGRICULTURAL AND RESIDENTIAL
(f)	SHOWN ON PLAN
(g)	SHOWN ON PLAN
(h)	PIPED MUNICIPAL
(i)	CLAY
(j)	SHOWN ON PLAN
(k)	STORM AND SANITARY SEWERS TO BE PROVIDED BY DEVELOPER
(1)	SHOWN ON PLAN

## OWNER'S CERTIFICATE

WE HEREBY CONSENT TO THE FILING OF THIS PLAN FOR APPROVAL

DATE	SIGNED:			
		1552843	ONTARIO	LIMITED

SURVEYOR'S CERTIFICATE I HEREBY CERTIFY THAT THE BOUNDARIES OF THE LANDS TO BE SUBDIVIDED AND THEIR RELATIONSHIP TO THE ADJACENT LANDS ARE ACCURATELY AND CORRECTLY SHOWN ON THIS PLAN.

DATE		
DAIL	•	

SIGNED: BRIAN COAD ONTARIO LAND SURVEYOR for VERHAEGEN·STUBBERFIELD·HARTLEY

BREWER · BEZAIRE INC.