


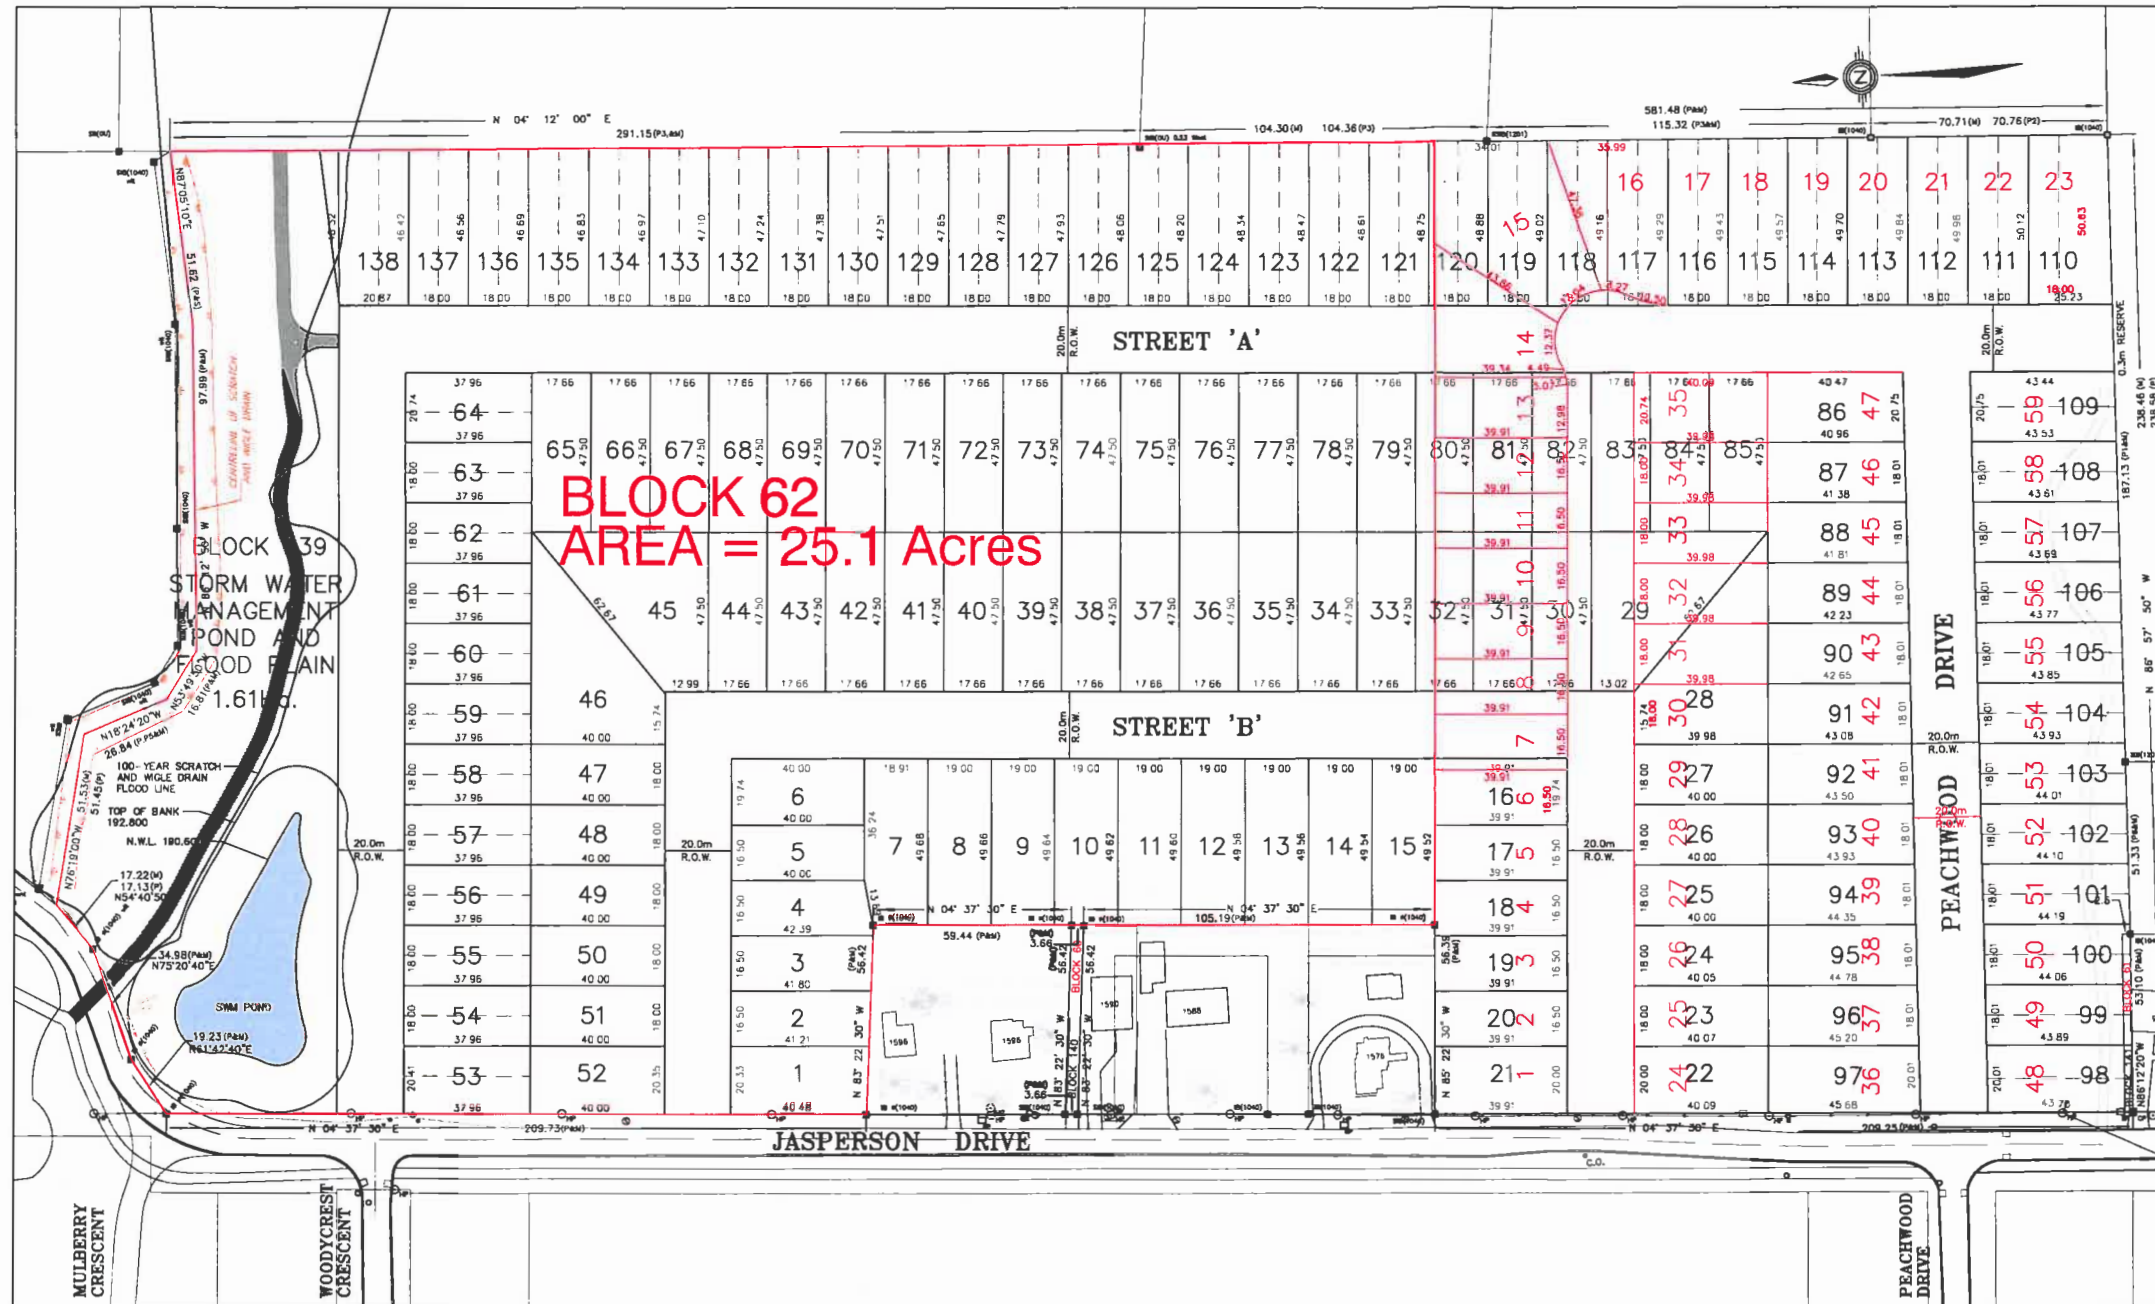

- ADDITIONAL INFORMATION REQUIRED UNDER SECTION 51(17) OF THE PLANNING ACT
- (a) SHOWN ON PLAN
 - (b) SHOWN ON KEY PLAN
 - (c) SHOWN ON PLAN
 - (d) RESIDENTIAL SINGLE DWELLING
 - (e) AGRICULTURAL AND RESIDENTIAL
 - (f) SHOWN ON PLAN
 - (g) SHOWN ON PLAN
 - (h) PIPED MUNICIPAL
 - (i) CLAY
 - (j) SHOWN ON PLAN
 - (k) STORM AND SANITARY SEWERS TO BE PROVIDED BY DEVELOPER
 - (l) SHOWN ON PLAN

OWNER'S CERTIFICATE
WE HEREBY CONSENT TO THE FILING OF THIS PLAN FOR APPROVAL
DATE Jan 16, 2018 SIGNED: Paul Remark
EDWARD REMARK & SONS LIMITED

SURVEYOR'S CERTIFICATE
I HEREBY CERTIFY THAT THE BOUNDARIES OF THE LANDS TO BE SUBDIVIDED AND THEIR RELATIONSHIP TO THE ADJACENT LANDS ARE ACCURATELY AND CORRECTLY SHOWN ON THIS PLAN.
DATE Feb 28, 2018 SIGNED: Brian Coad
BRIAN COAD
ONTARIO LAND SURVEYOR
for VERHAEGEN-STUBBERFIELD-HARTLEY
BREWER-BEZAIRE INC.

APPENDIX B - 2018

LAND USE SCHEDULE

USE	RESIDENTIAL UNITS	AREA(Ha)
SINGLE FAMILY DWELLING	59	4.76
SEMI-DETACHED	0	0
R.O.W.		1.22
INSTITUTION (BLOCK 62)		10.16
BLOCKS 60 & 61		0.03
TOTAL	59	16.17

LAND USE SCHEDULE

USE	RESIDENTIAL UNITS	AREA(Ha)
SINGLE FAMILY DWELLING	85	7.19
SEMI-DETACHED	106	4.38
R.O.W.		2.96
SWM POND AND FLOOD PLAIN		1.61
BLOCKS 140 & 141		0.03
TOTAL	191	16.17



NO.	REVISION	DATE	BY	APP.
3.	RED LINE REVISION	JAN. 16, 2018	D.L.	R.C.S.
2.	SUBMITTED TO COUNTY OF ESSEX	FEB 28, 2013	A.B.	R.C.S.
1.	SUBMITTED TO TOWN	JAN 16, 2013	R.C.S.	R.C.S.

DESIGN R.C.S.	PROJECT NO. 12-216
CHECKED R.C.S.	SHEET NO. 1
DRAWN S.M.L.	OF 1
CHECKED R.C.S.	
DATE JAN 2013	
SCALE 1:1000	

AMENDED DRAFT PLAN